

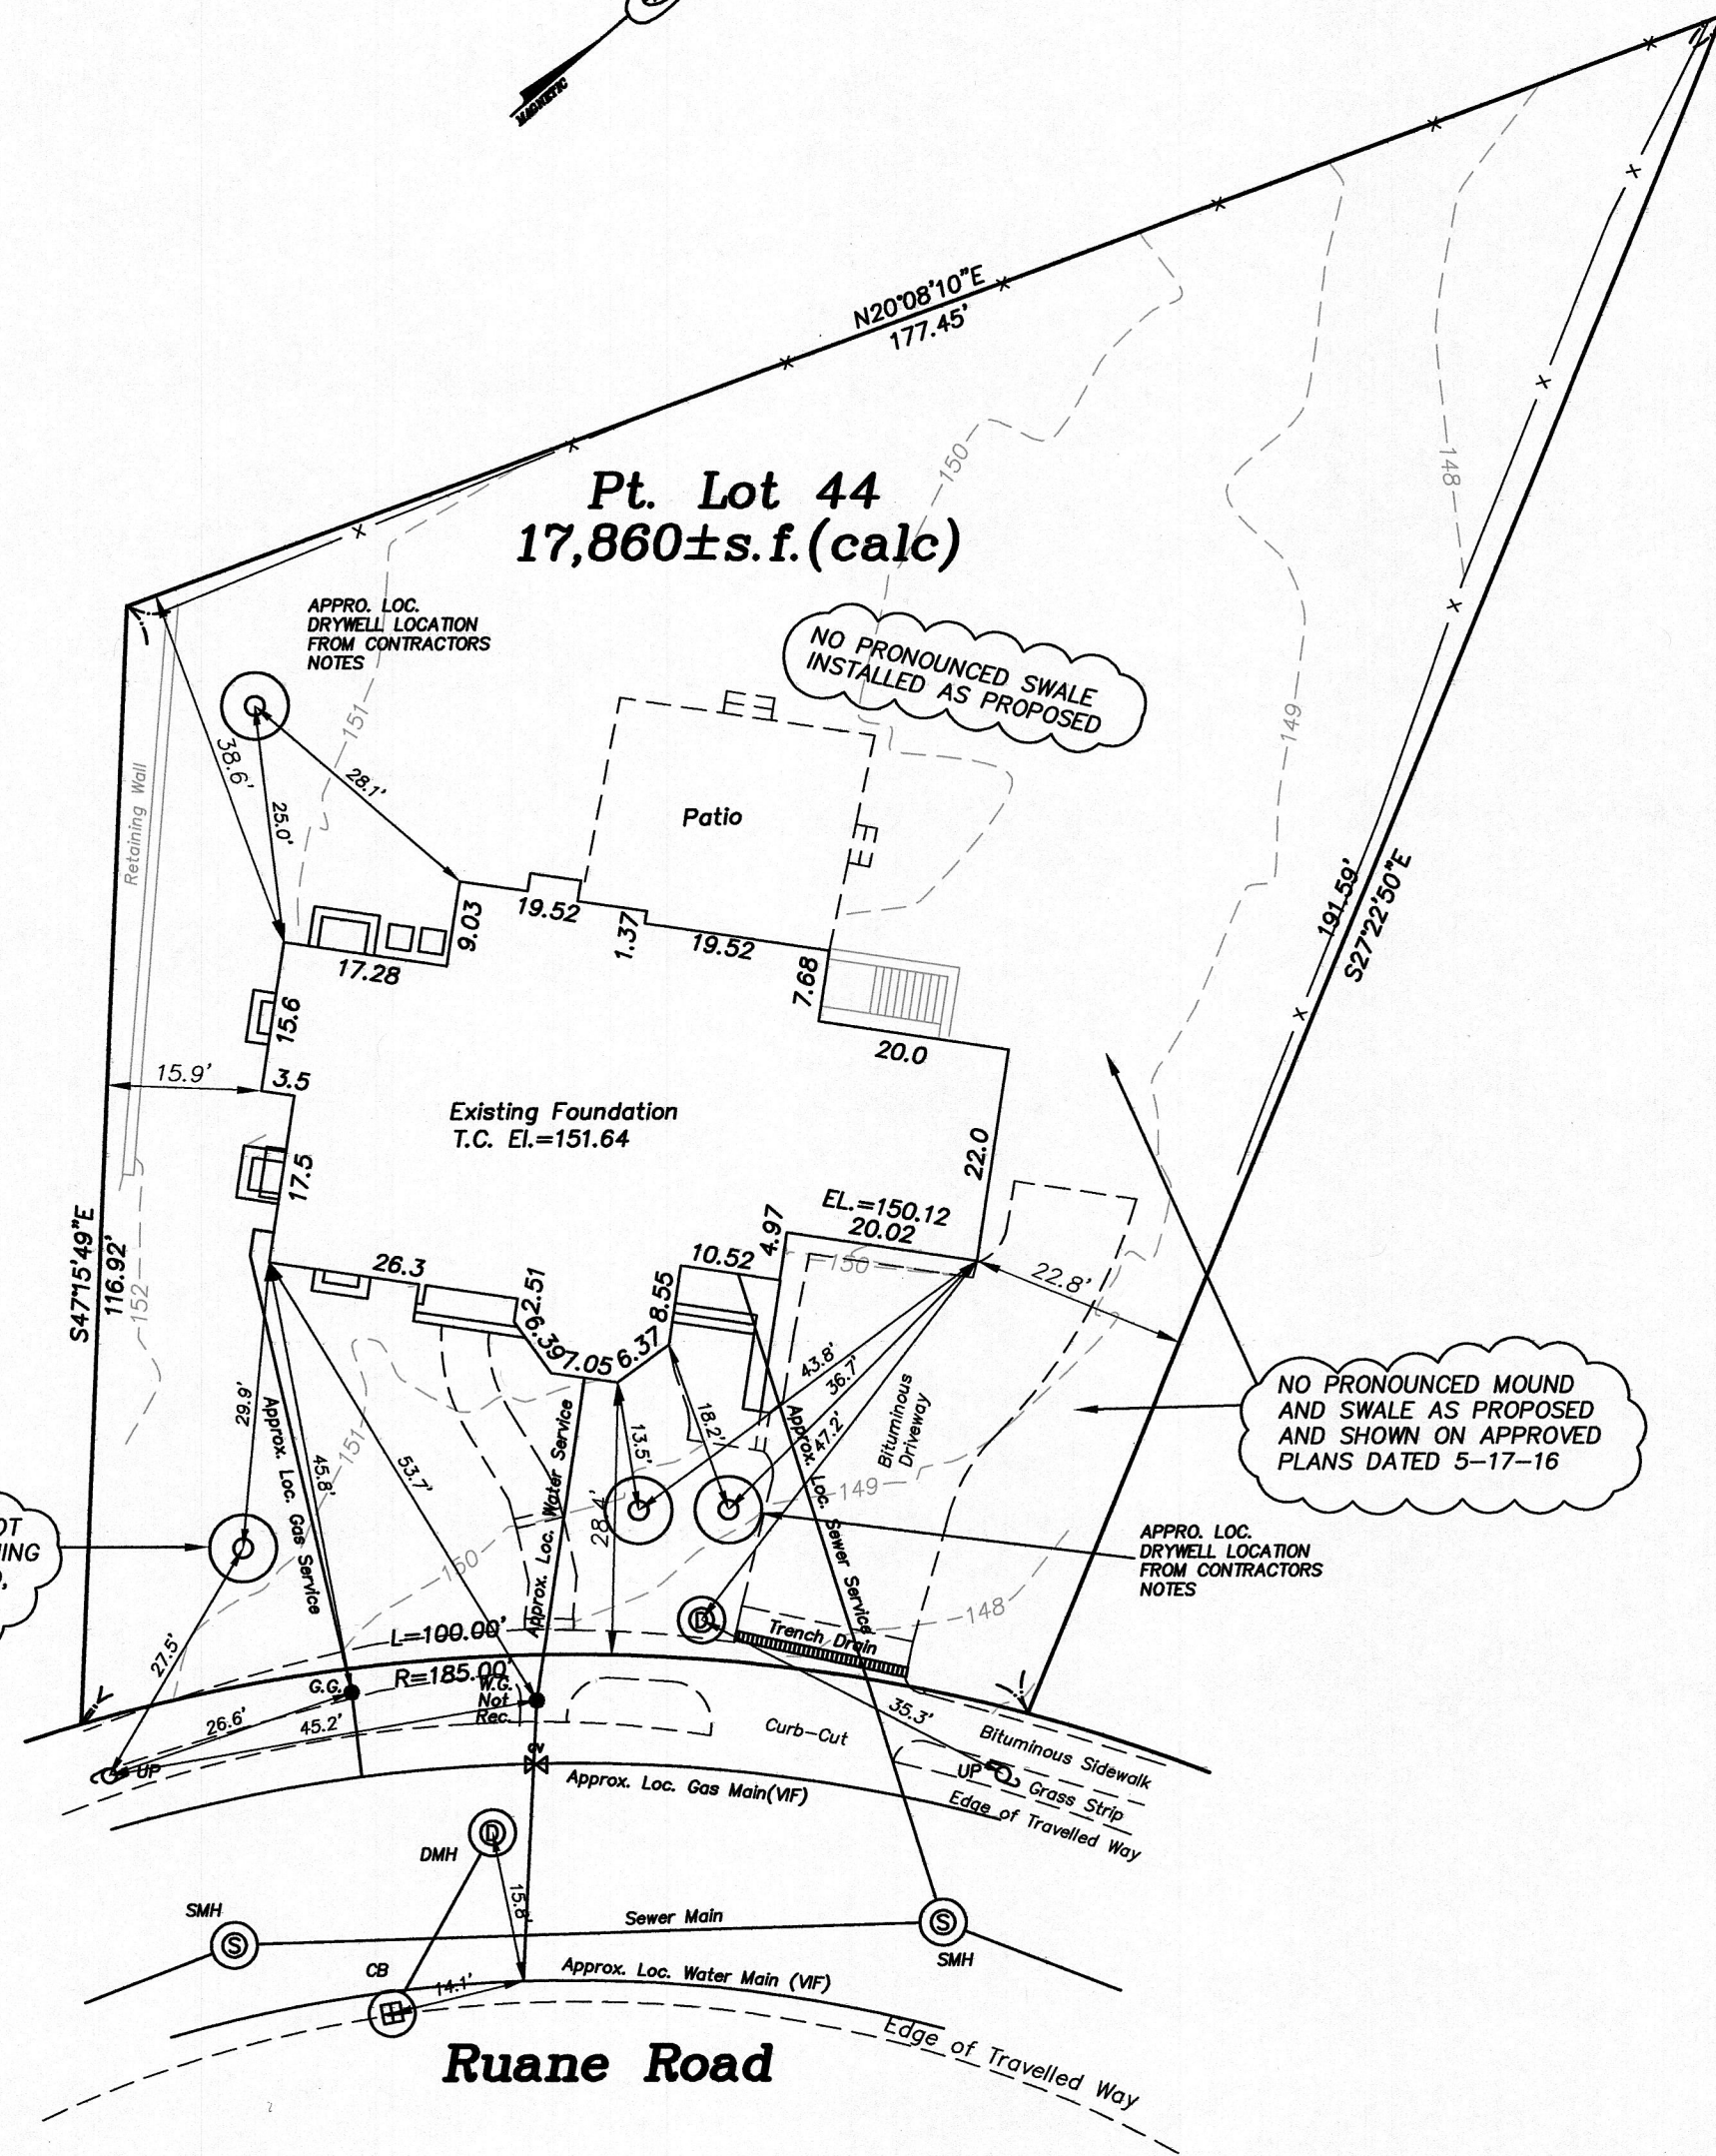


Dig Safe
 Excavators
 Before you dig contact the Dig Safe Center.
 To prevent damage to telephone, gas or electric underground facilities of member utilities, call toll free
 Massachusetts state law requires notification at least three business days before you start digging operations. In an emergency, call immediately.

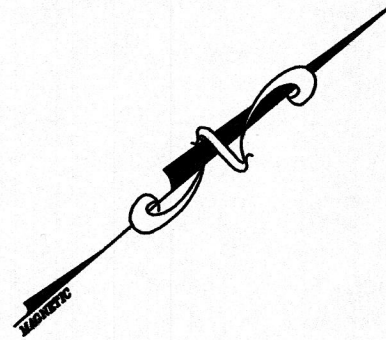

CB FRAME & GRATE NOT INSTALLED OVER LEACHING DRYWELL AS PROPOSED, ALL LOCATIONS PER CONTRACTOR

NO PRONOUNCED MOUND AND SWALE AS PROPOSED AND SHOWN ON APPROVED PLANS DATED 5-17-16

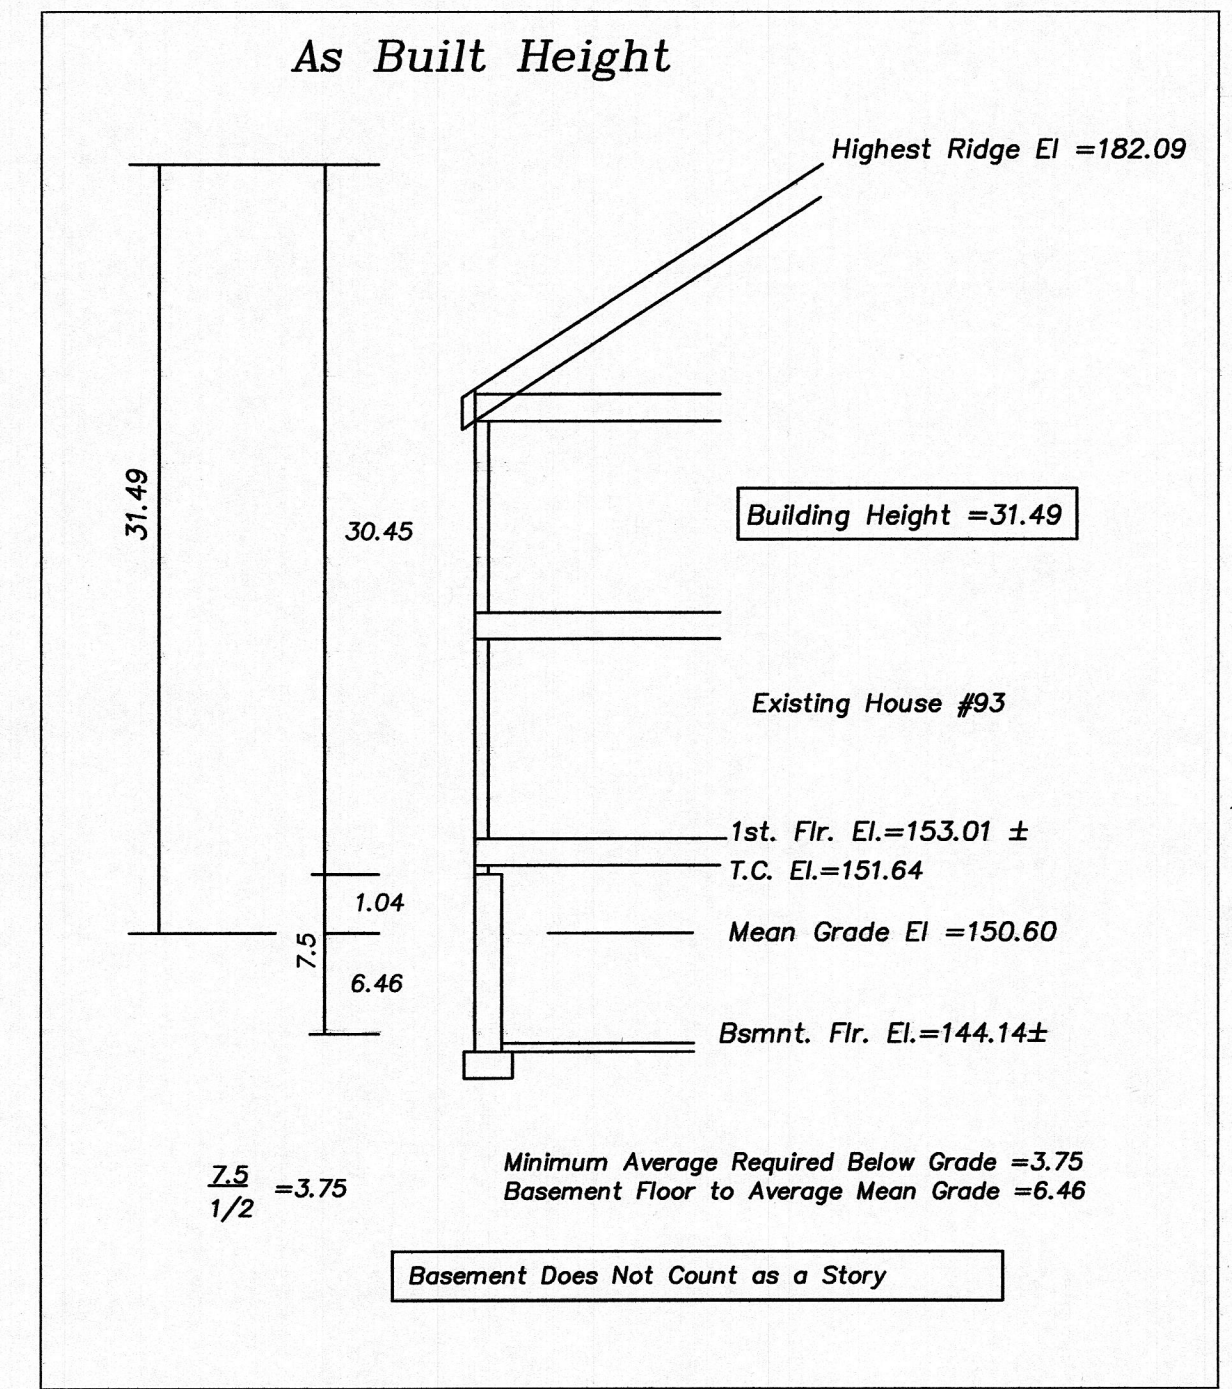

As Built Coverages:
 Open Space=78.52%
 Structure=15.17%

~As Built Site Plan~	
93 Ruane Road	
Newton, Massachusetts	
Scale: 1"=20'	December 13, 2017
VERNE T. PORTER Jr., PLS	
Land Surveyors - Civil Engineers	
354 Elliot Street, Newton, Ma. 02464	
Design By:	Checked By:
Sheet 1 of 1	Job #14061