

Middlesex Registry of Deeds, So. Dist.
CAMBRIDGE, MASS.


Plan Number 70(Aof2) of 1983
Rec'd JAN 21, 1983 at 1:11 P.M.
With DECL. CONDMN. Dec. No. 332
CHRISTIANE DELESSERT

Recorded, Book 14869 Page 208

John F. Fayoull
Register

FEE 26.00
BY R

FOR REGISTRY USE ONLY

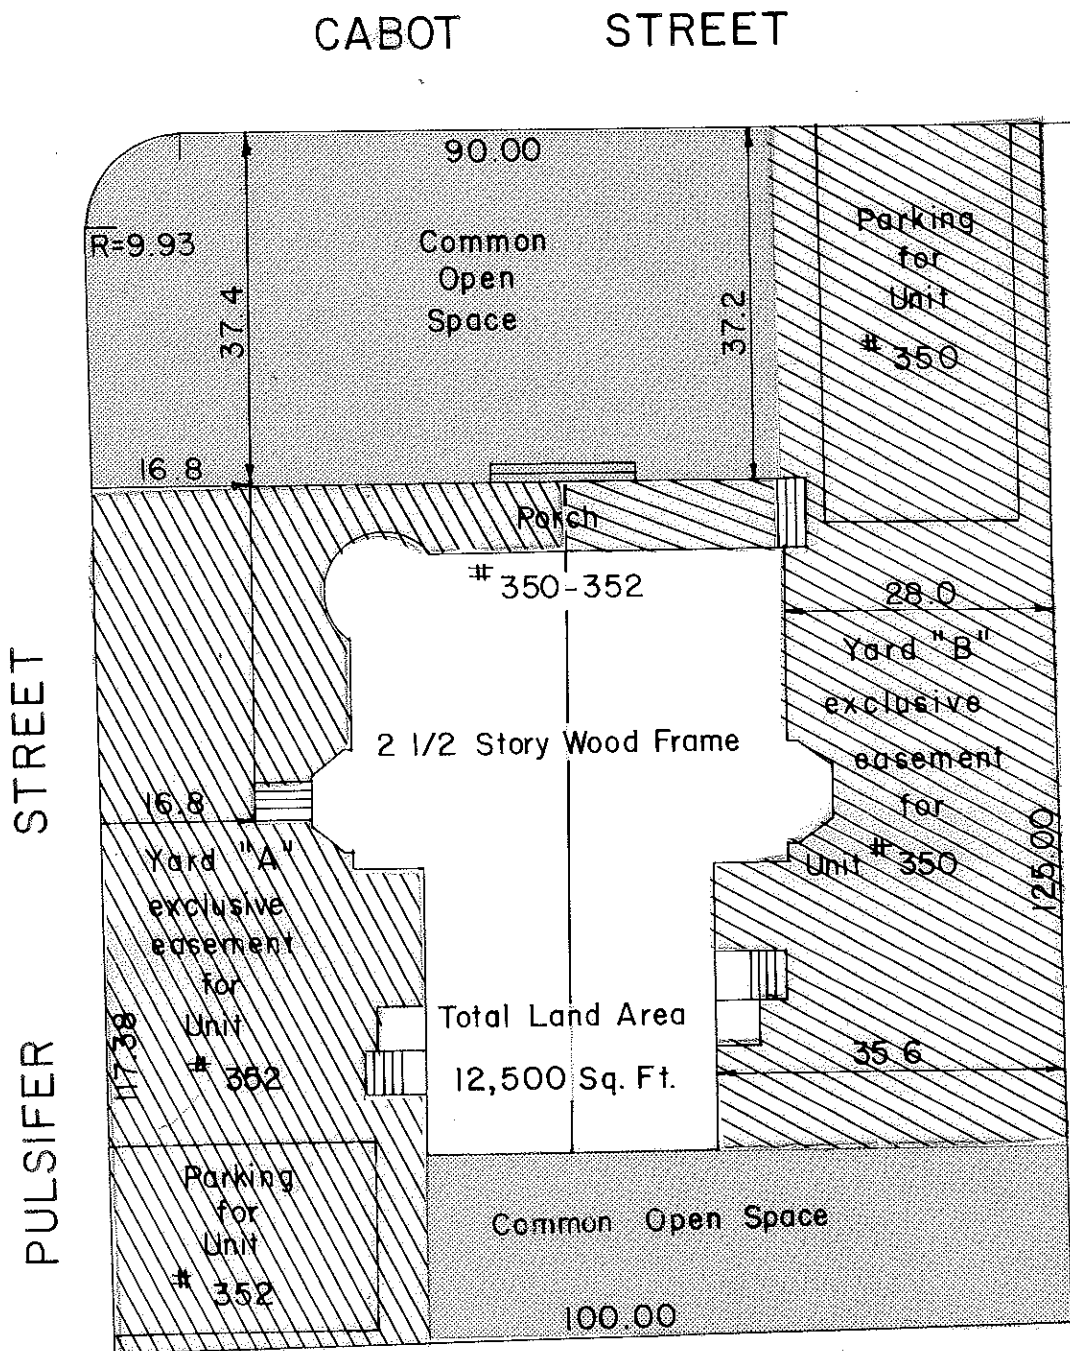

N/F THOMAS E. BREW JR.



Nathan Rossman

I CERTIFY THAT THIS PLAN HAS BEEN PREPARED IN CONFORMITY WITH THE RULES AND REGULATIONS OF THE REGISTERS OF DEEDS OF THE COMMONWEALTH OF MASSACHUSETTS.

11-30-82

Nathan Rossman

PLAN OF LAND
OF


350-352 CABOT STREET CONDOMINIUMS
350-352 CABOT STREET
NEWTON, MASS.

SCALE : 1" = 20'

AUGUST, 1982

MASS BAY SURVEY INC.


NEWTON, MASS.

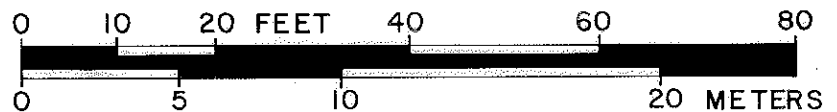


75/0 145/0 2000

70-1



PLAN NUMBER 70(Aof2) OF 1983
RECORDED, BOOK 14869 PAGE 208

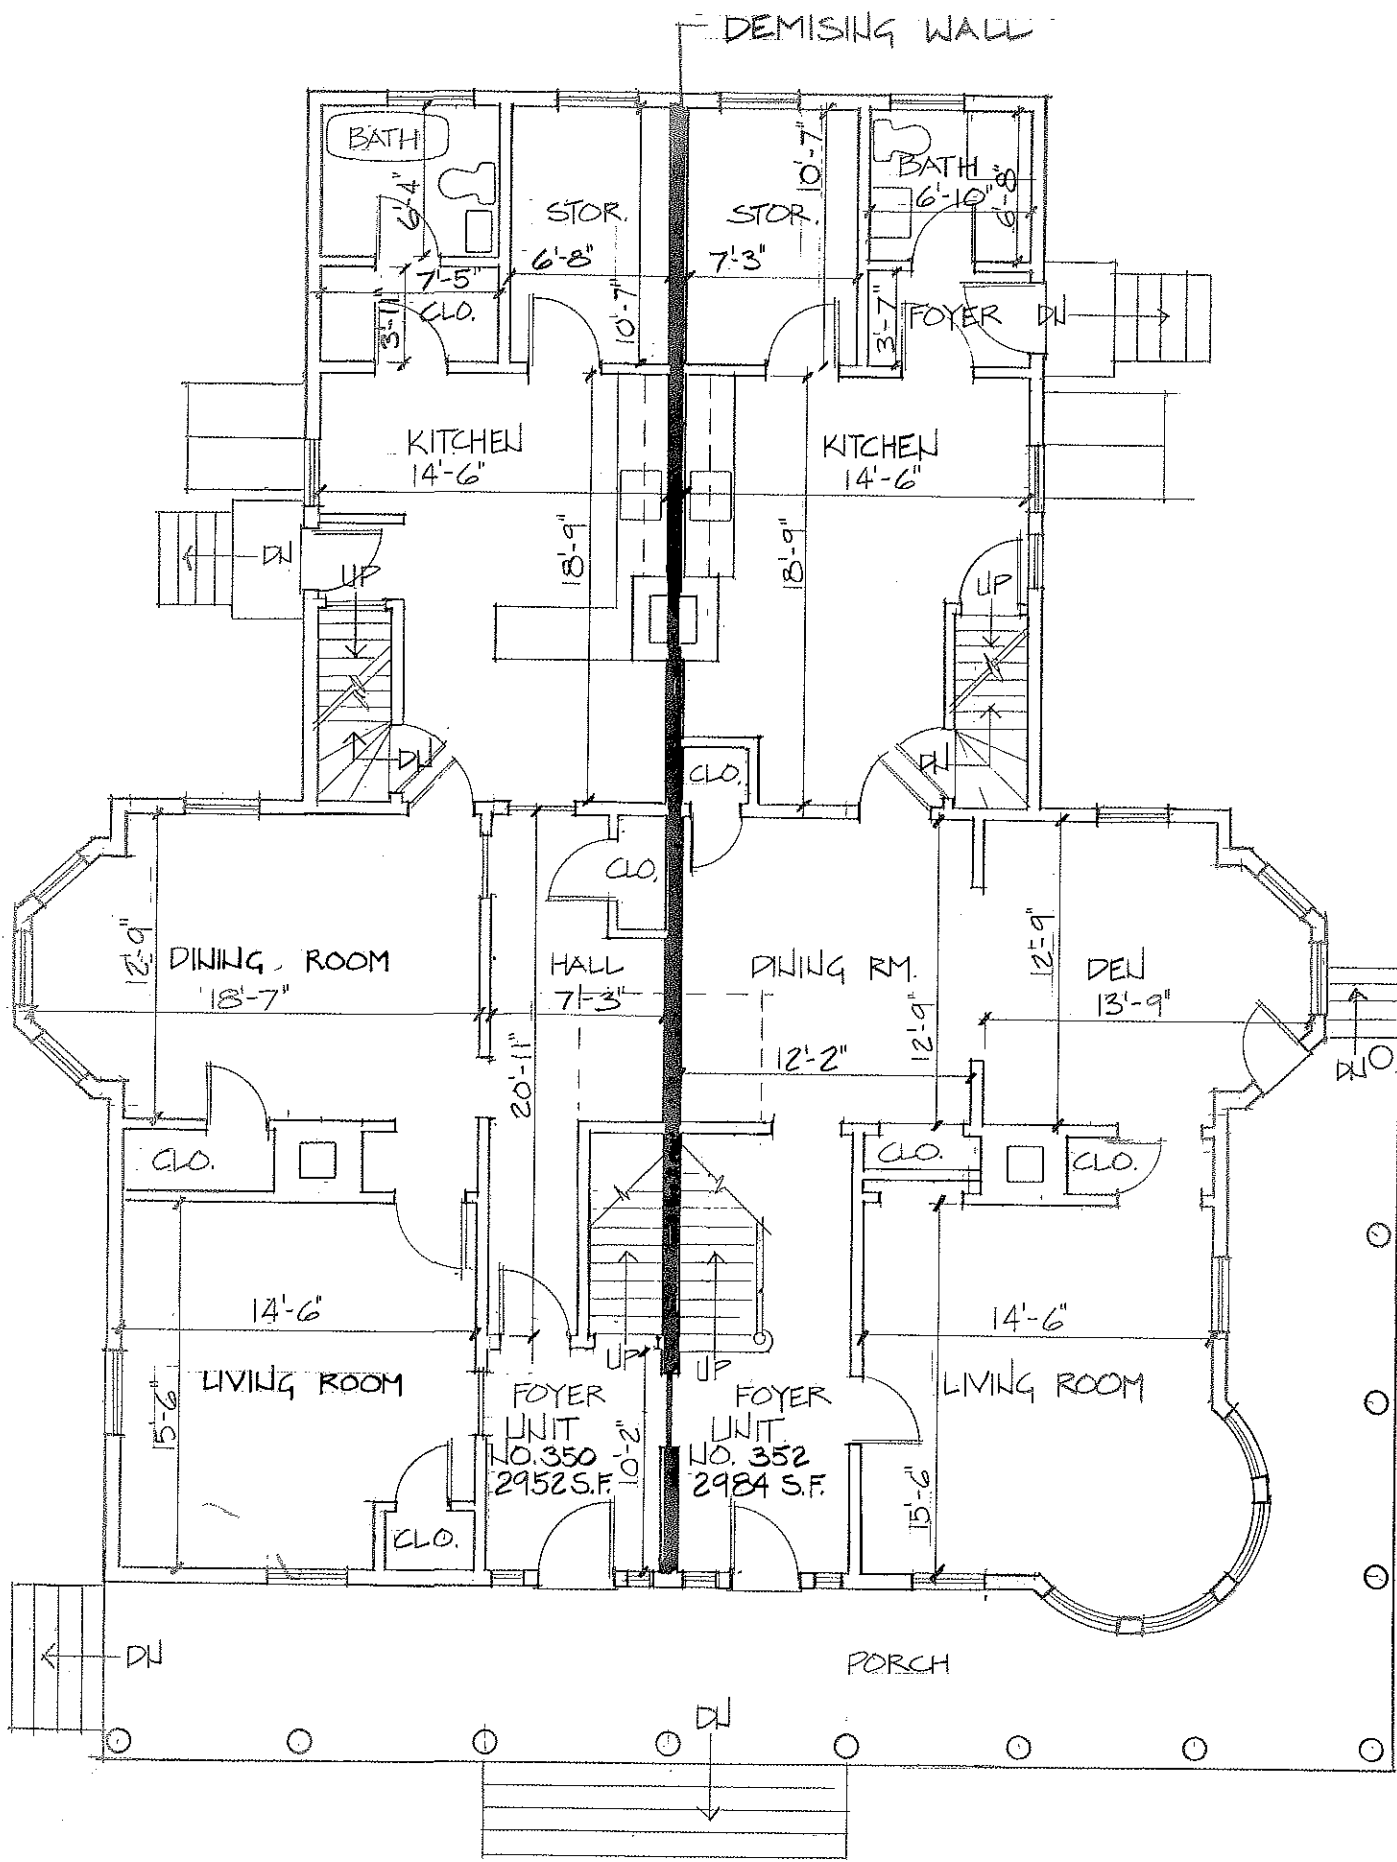


1ST FLOOR PLAN

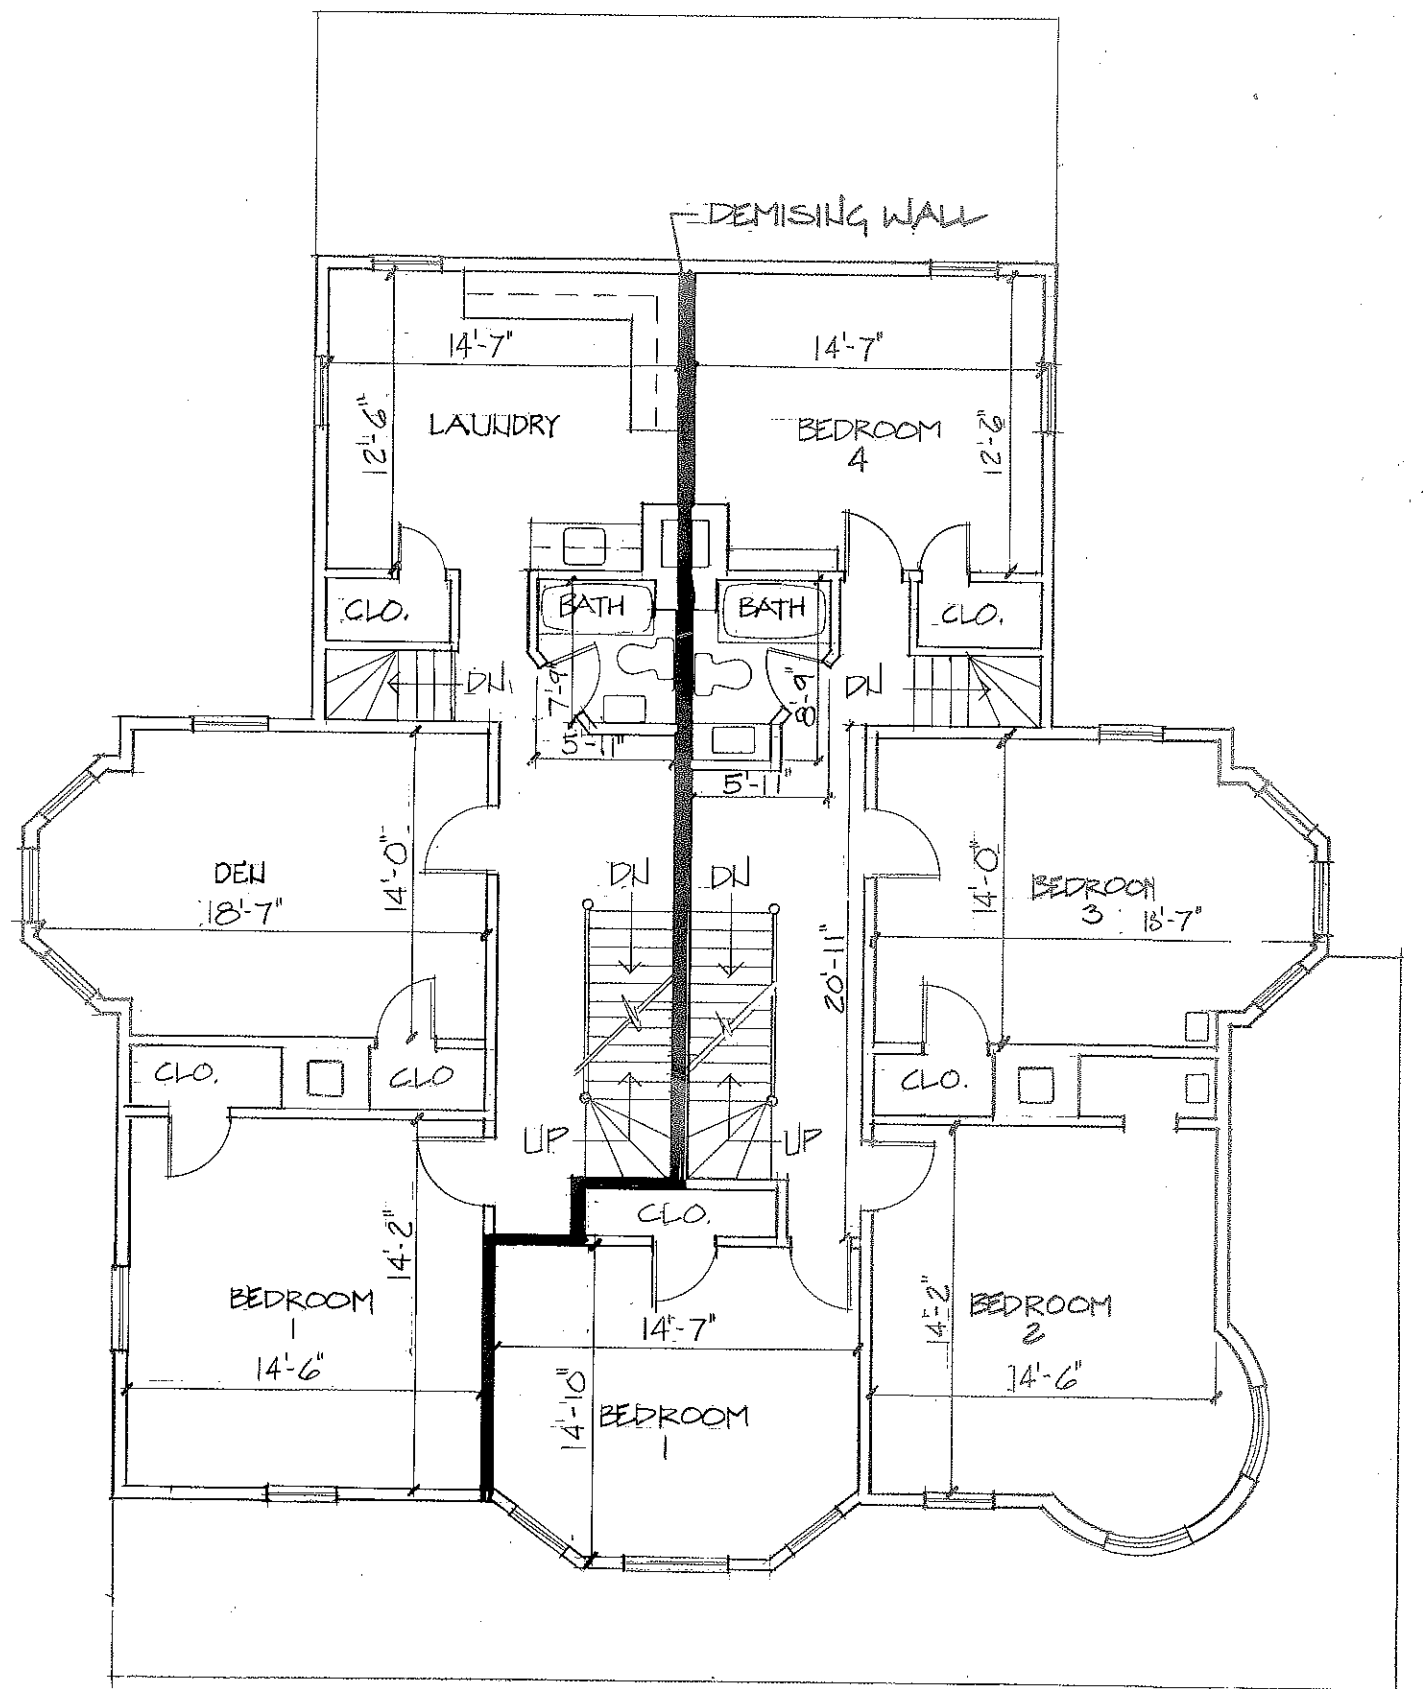

2ND FLOOR PLAN

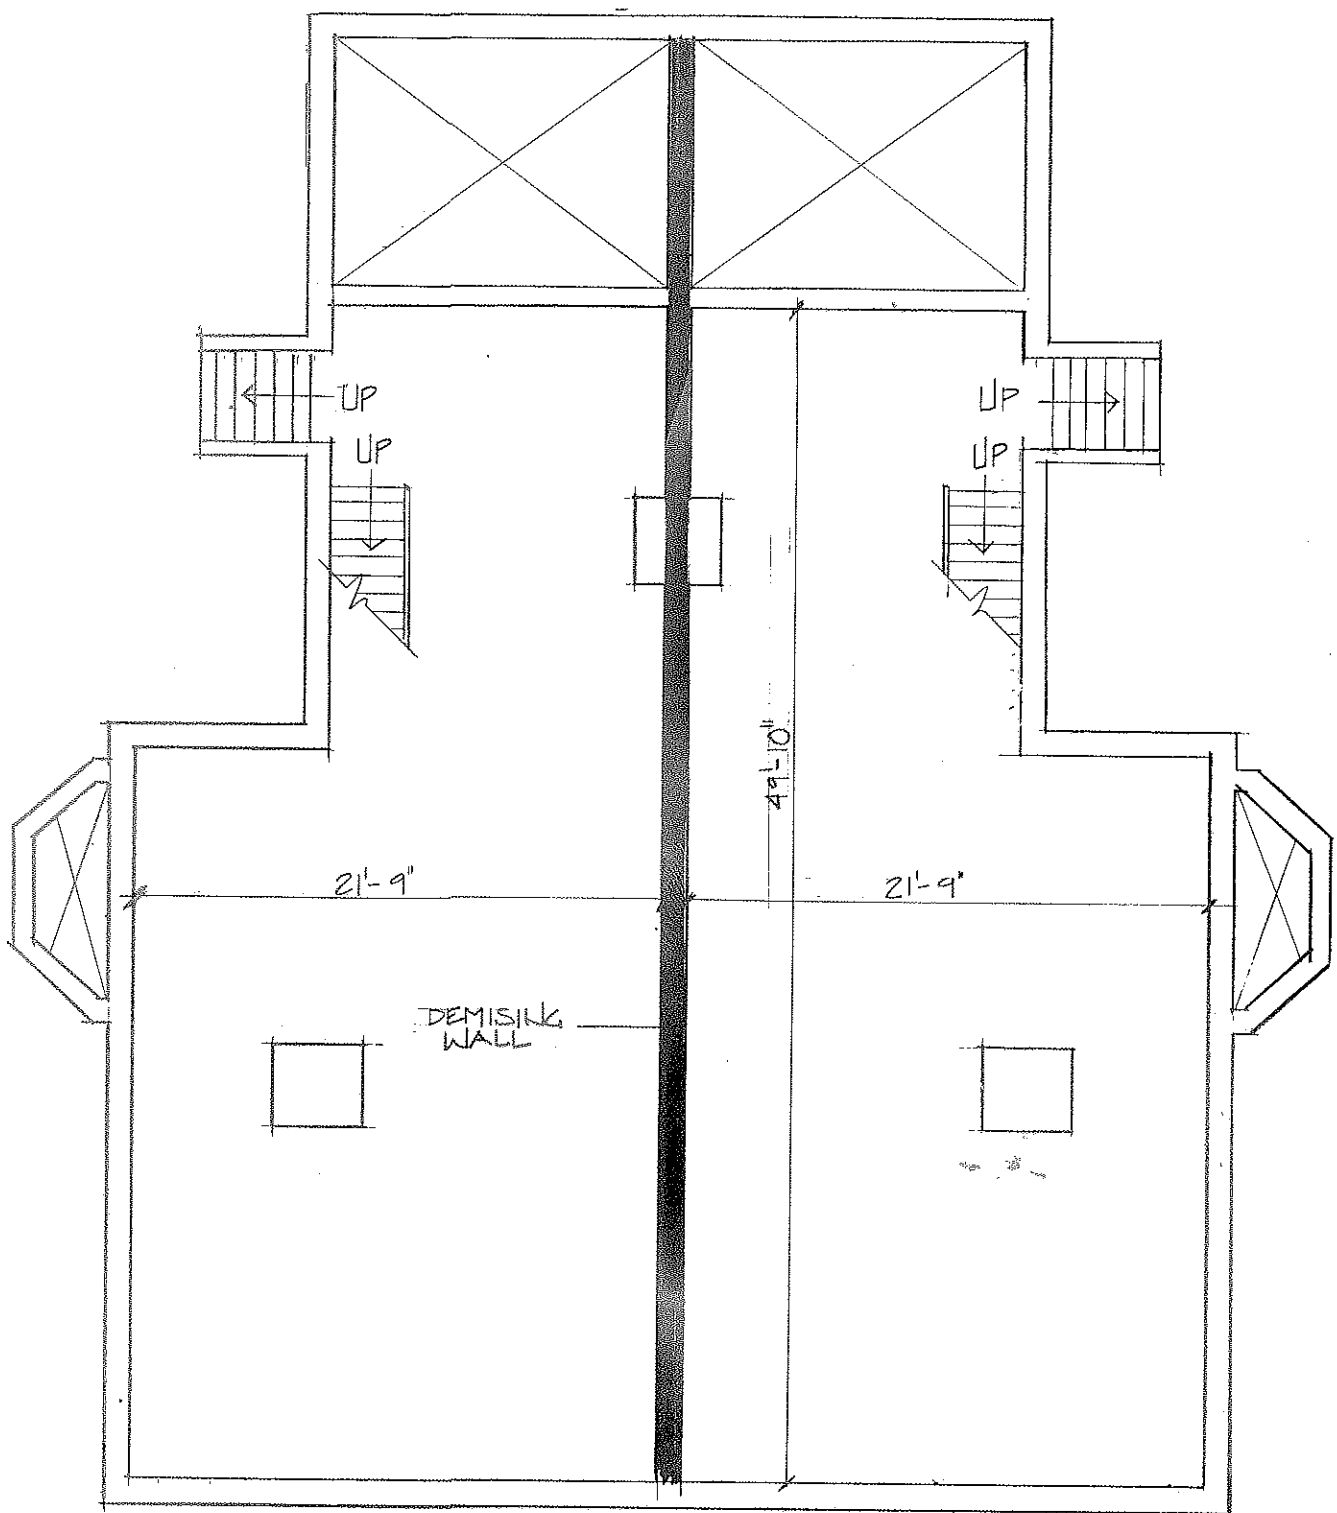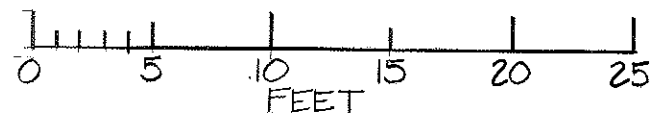

BSMT. FLOOR PLAN

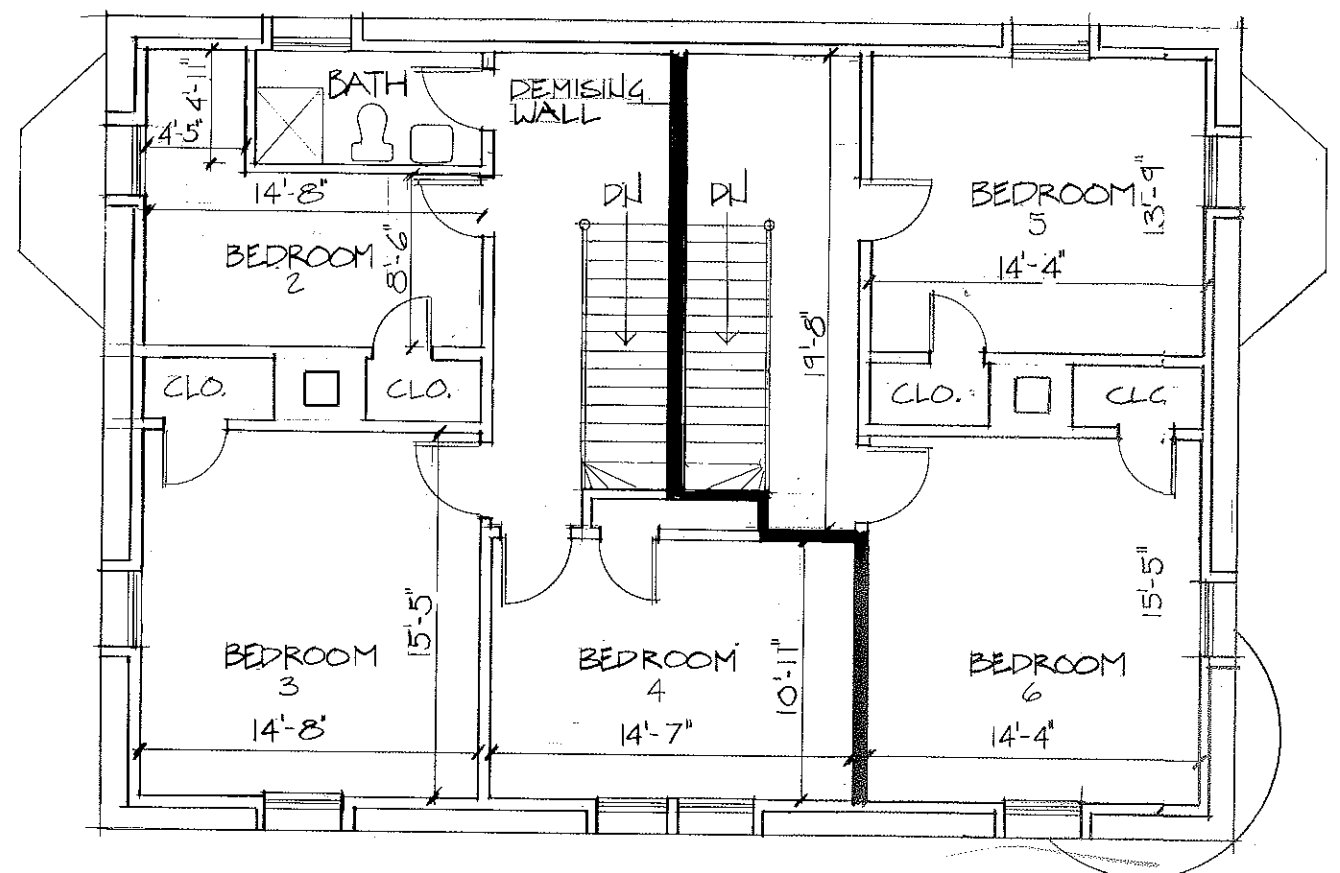

3RD FLOOR PLAN

CERTIFICATION:
 I CERTIFY THAT THIS PLAN CONFORMS WITH THE RULES AND REGULATIONS OF THE REGISTERS OF DEEDS OF THE COMMONWEALTH OF MASSACHUSETTS. THE WITHIN PLAN OF THE 350-352 CABOT STREET CONDOMINIUMS, 350-352 CABOT STREET, NEWTON, MASSACHUSETTS, FULLY AND ACCURATELY DEPICTS THE LAYOUT, LOCATION, UNIT NUMBERS, AND DIMENSIONS OF ALL CONDOMINIUM UNITS WITHIN SAID BUILDING, AS BUILT AND IN EXISTENCE ON 13 AUGUST 1982, AND THAT THE BUILDING HAS NO NAME.

SUBSCRIBED TO UNDER PAINS AND PENALTIES OF PERJURY THIS 13 OF AUGUST, 1982
 SIGNATURE: *John K. Smith*

REGISTRY USE:
 Middlesex Registry of Deeds, So. Dist.
 CAMBRIDGE, MASS.
 Plan Number *10 (Boe 2)* of 1983
 Rec'd *AN 21* 1983 at *11.11 a.m.*
 With *DCLN. COADMN.* Doc. No. *332*
CHRISTIANE DELESSERT

Recorded, Book *14869* Page *208*

FEE *26.00*
John F. Jazouli
 Register

CityDesign

CityDesign Collaborative, Inc.
 334 Boylston Street
 Boston, Mass 02116 617/536-1331

TITLE:
 350-352 CABOT ST.
 CONDOMINIUMS
 SCALE:
 1/8" = 1'-0"
 350-352 CABOT STREET
 NEWTON, MASSACHUSETTS

