


213209a.dwg (2/2013)

LEGEND

BUILDING	
PROPERTY LINE W/ BEARING DISTANCE	
CONTOUR	
STOCKADE FENCE	
CHAINLINK FENCE	
PICKET FENCE	
SEWER LINE	
DRAIN LINE	
WATER LINE	
GAS LINE	
GAS VALVE	
WATER VALVE	
DRAIN MANHOLE	
SEWER MANHOLE	
CATCH BASIN	
UTILITY POLE	
LIGHT POLE	
DECIDUOUS TREE	
CONIFEROUS TREE	

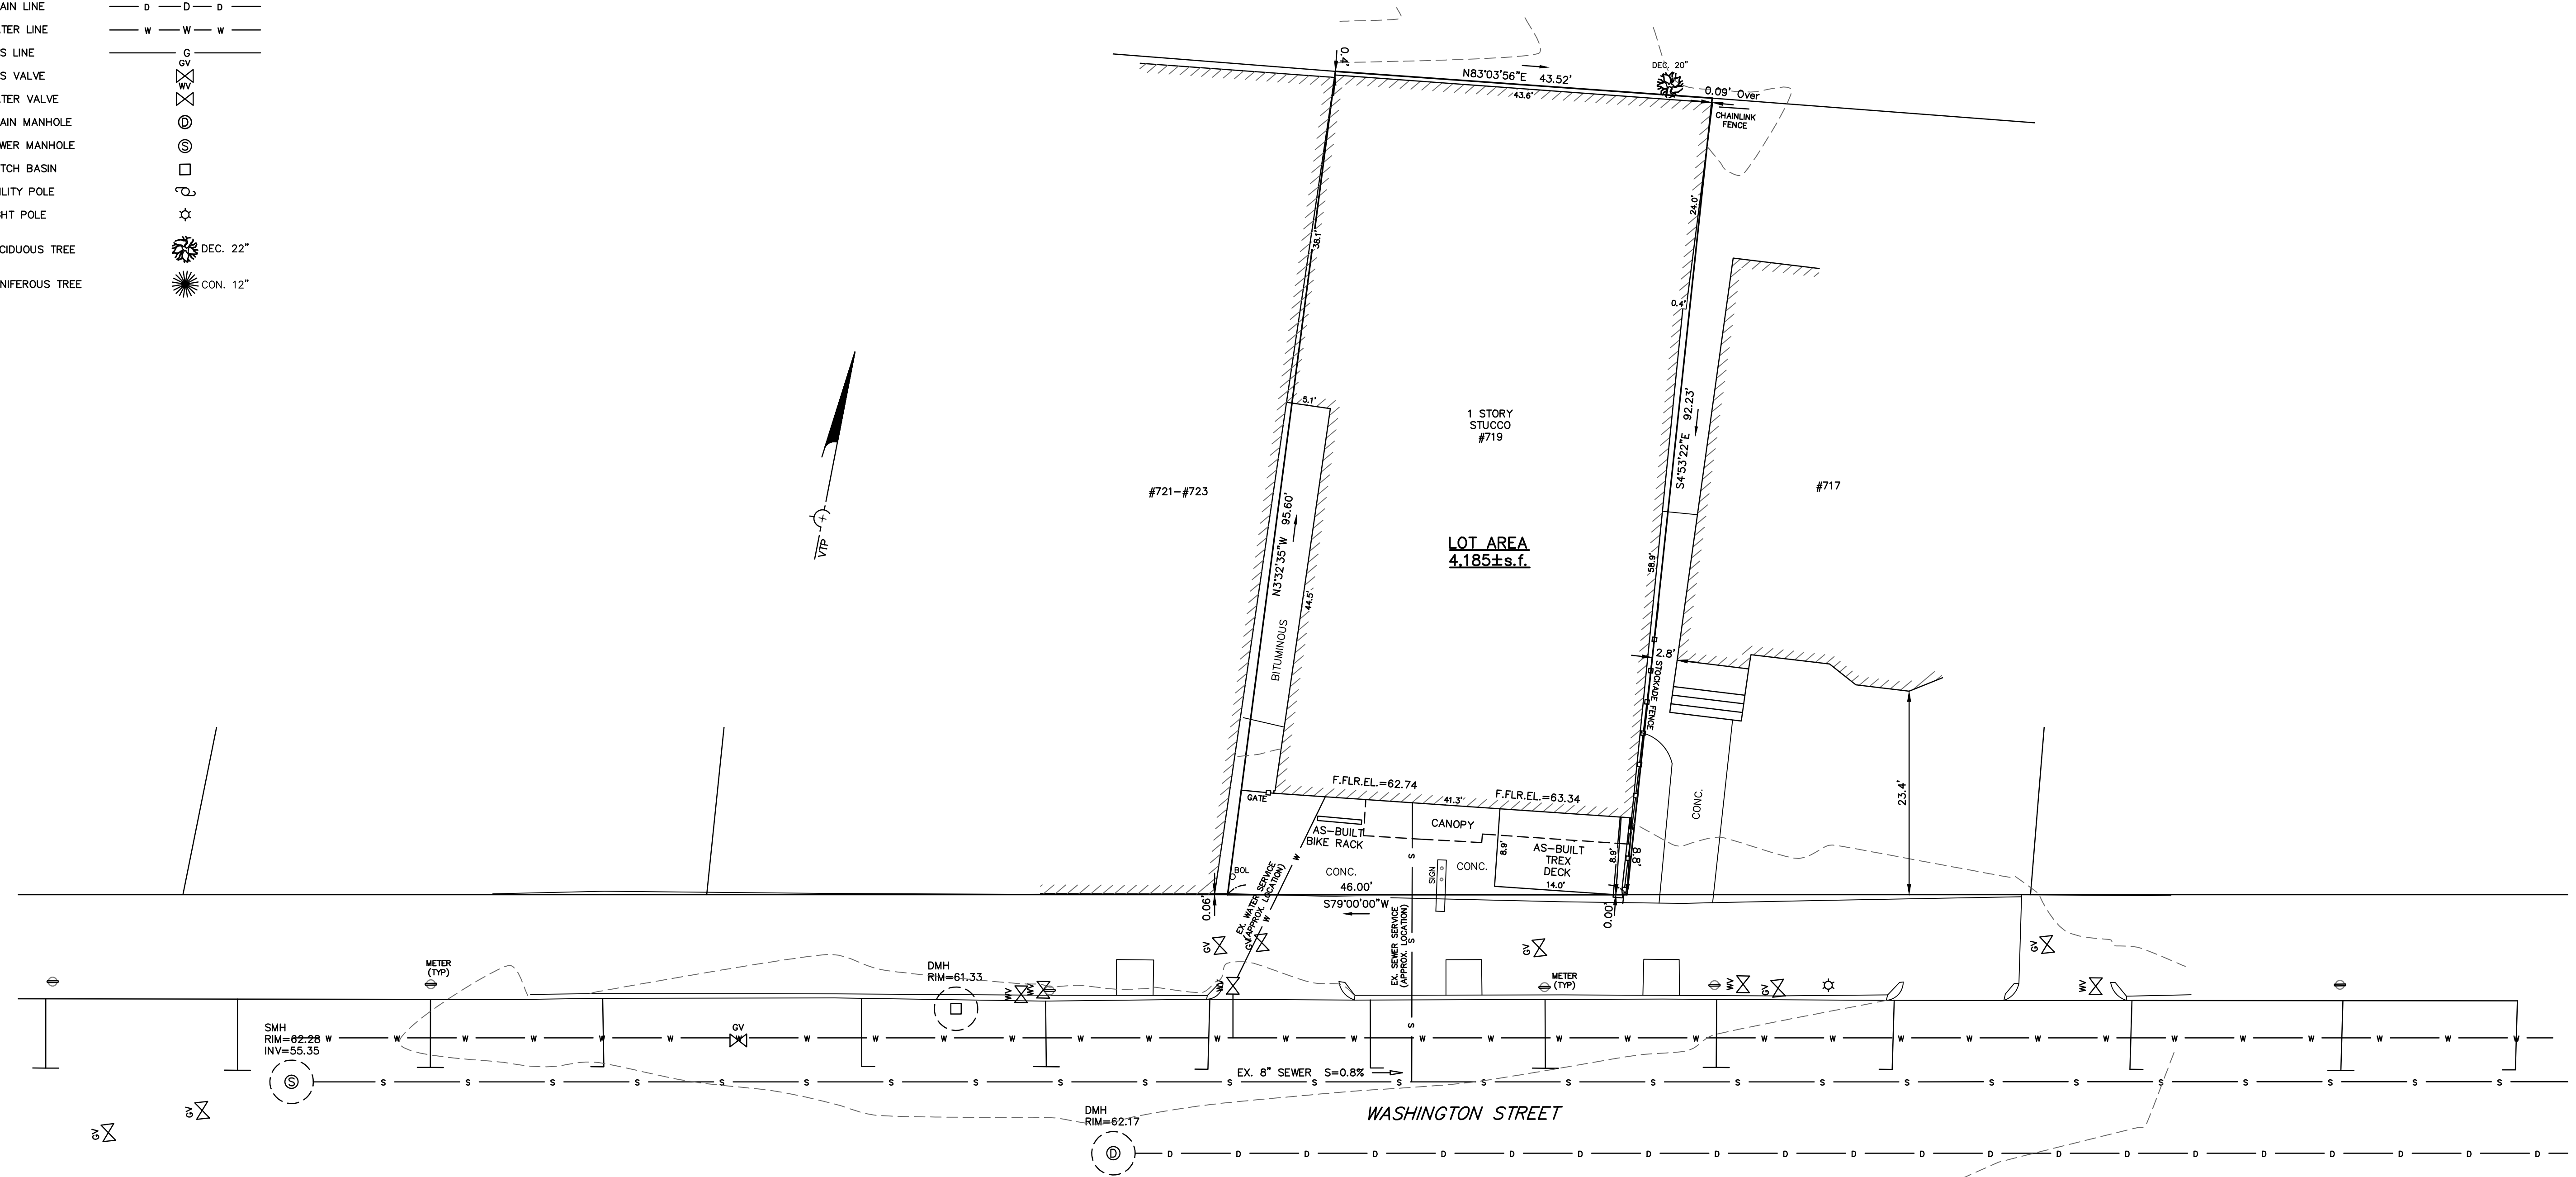

ZONING CHART		
NEWTON, MASSACHUSETTS		
ZONE:	REGULATION	EXISTING
BU-2	80.0'	46.0'
	Avg. 11.73'	8.8'
	0	0.4'
	24' / 2 Story	1 Story

**TOPOGRAPHIC SITE PLAN
NEWTON, MASSACHUSETTS**

SHOWING AS-BUILT CONDITIONS
AT #719 WASHINGTON STREET

SCALE: 1in.=10ft. DATE: NOVEMBER 11, 2014

PROJECT: 213209
VTP
ASSOCIATES
INC.

LAND SURVEYORS - CIVIL ENGINEERS. 132
ADAMS STREET 2ND FLOOR SUITE 3
NEWTON, MA 02458
(617) 332-8271

SHEET 1 OF 1

