


CHRISTINA STREET
 (PUBLIC ~ 40' WIDE)
 GRANITE CURB
 CITY OF NEWTON WATER EASEMENT

- LEGEND**
- AREA DRAIN
 - BENCH MARK
 - CONCRETE RETAINING WALL
 - DRAIN MANHOLE
 - ELECTRICAL MANHOLE
 - GAS GATE
 - GUY WIRE
 - HYDRANT
 - OVERHEAD WIRES
 - SEWER MANHOLE
 - SEWER VALVE
 - TELEPHONE MANHOLE
 - TRAFFIC CONTROL BOX
 - TRASH RECEPTACLE
 - UNDERGROUND UTILITIES
 - WATER GATE
 - WROUGHT IRON FENCE
 - WOOD UTILITY POLE
 - WOOD UTILITY POLE W/LIGHT
 - WATER SPRIG
 - AUTO SPRINKLER/IRIG DEPARTMENT CONNECTION
 - ELECTRICAL OUTLET
 - CLEAN OUT

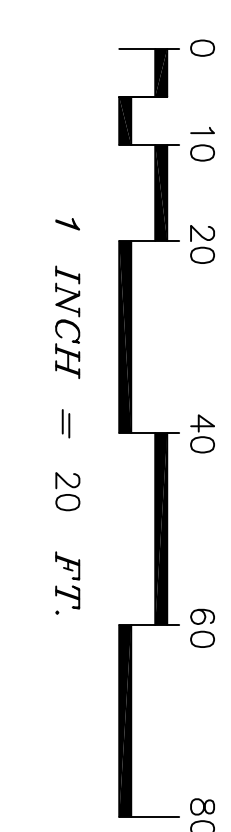

<p>R.E. Cameron & Associates, Inc. LAND SURVEYORS - CIVIL ENGINEERS 681 WASHINGTON STREET NORWOOD, MA 02062 (781) 769-1777 Fax (781) 769-8644</p>		
<p>AS-BUILT PLAN FUSION LEARNING ACADEMY 320 NEDHAM STREET NEWTON, MASSACHUSETTS</p>		
<p>2866FLA1</p>		
<p>Revisions</p>		
No.	Date	Description
1	11/9/2015	UPDATE
2	2/27/18	SITE PLAN
<p>SCALE: 1"=20' DATE: 3/10/15 DRAWN BY: SLS MATH- JOB NUMBER: 2866 CHECKED BY: COUNTY: MIDDLESEX</p>		
<p>TITLE: AS-BUILT PLAN FUSION LEARNING ACADEMY 320 NEDHAM STREET NEWTON, MASSACHUSETTS</p>		
<p>SHEET NUMBER: 2866</p>		