

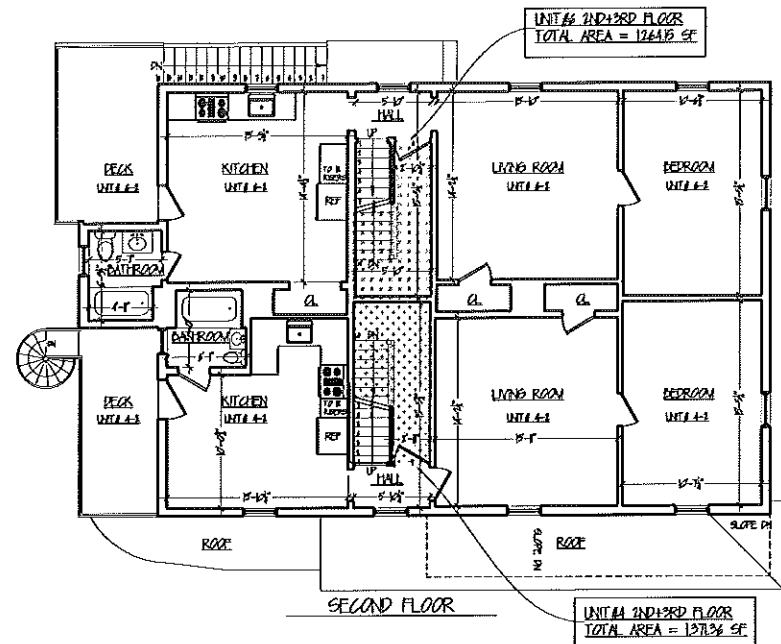


I HEREBY CERTIFY THAT THIS PLAN FULLY AND ACCURATELY REPRESENTS THE LOCATION AND DIMENSIONS OF THE BUILDING AS-BUILT AND FULLY LISTS THE UNITS CONTAINED THEREIN FULLY AND ACCURATELY.

Peter Sacha
PETER SACHA

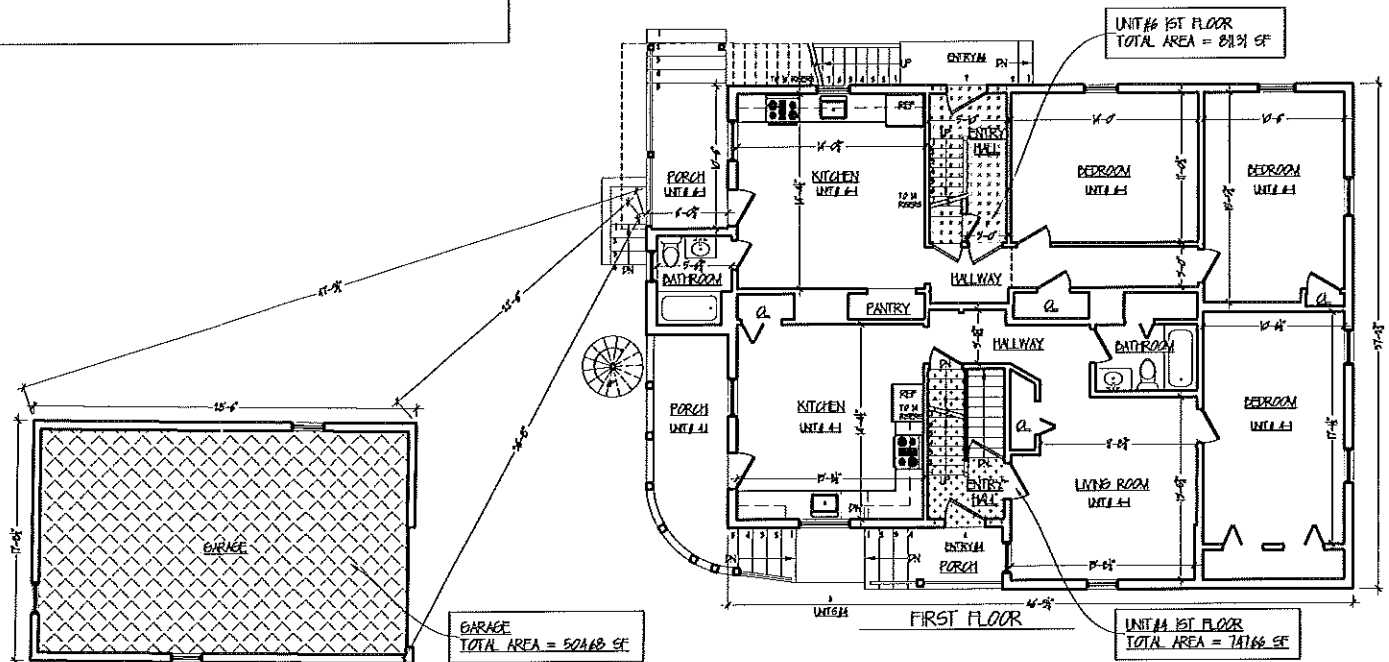

UNIT # 4 1ST FLOOR	FIRST FLOOR & AS NOTED	UNIT 1ST FLOOR TOTAL AREA = 747.66 SF
UNIT # 4 2ND FLOOR	SECOND FLOOR & AS NOTED	UNIT 2ND+3RD FLOOR TOTAL AREA = 13713.6 SF
UNIT # 6 1ST FLOOR	FIRST FLOOR & AS NOTED	UNIT 1ST FLOOR TOTAL AREA = 8131 SF
UNIT # 6 2ND FLOOR	SECOND FLOOR & AS NOTED	UNIT 2ND+3RD FLOOR TOTAL AREA = 12641.5 SF

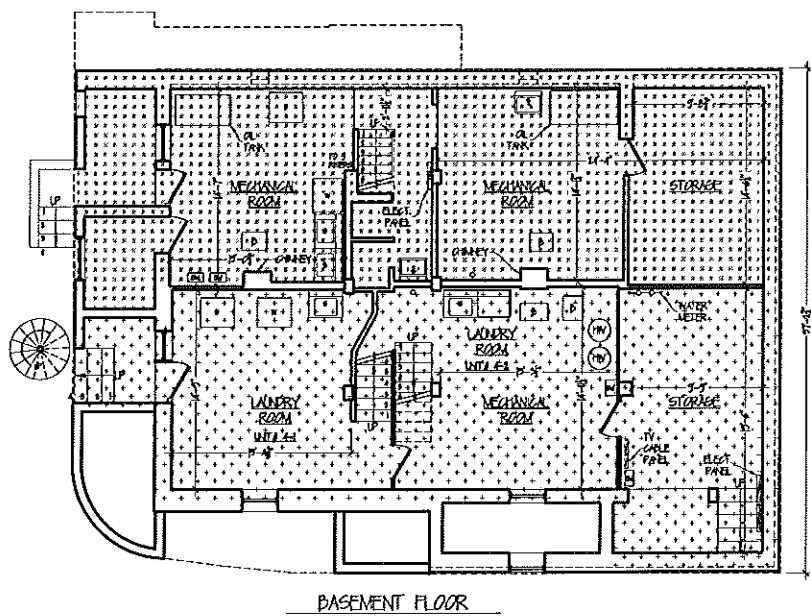

4-4 Middle St - 3 - Arch. ENVELOPE

FLOOR PLANS
4-4 MIDDLE ST, NEWTON, MA SCALE AS NOTED

Peter Sacha Architect N.C.A.R.A. - A.I.A.
20 Hunter St.
Newton, MA 02465

DATE & REVISION
08/14/14
08/15/14

TITLE SHEET

Tel: 617-551-5777 or Cell 617-512-5043
E-Mail: peter@sacha.com
www.peterusarchitect.com

A-0