
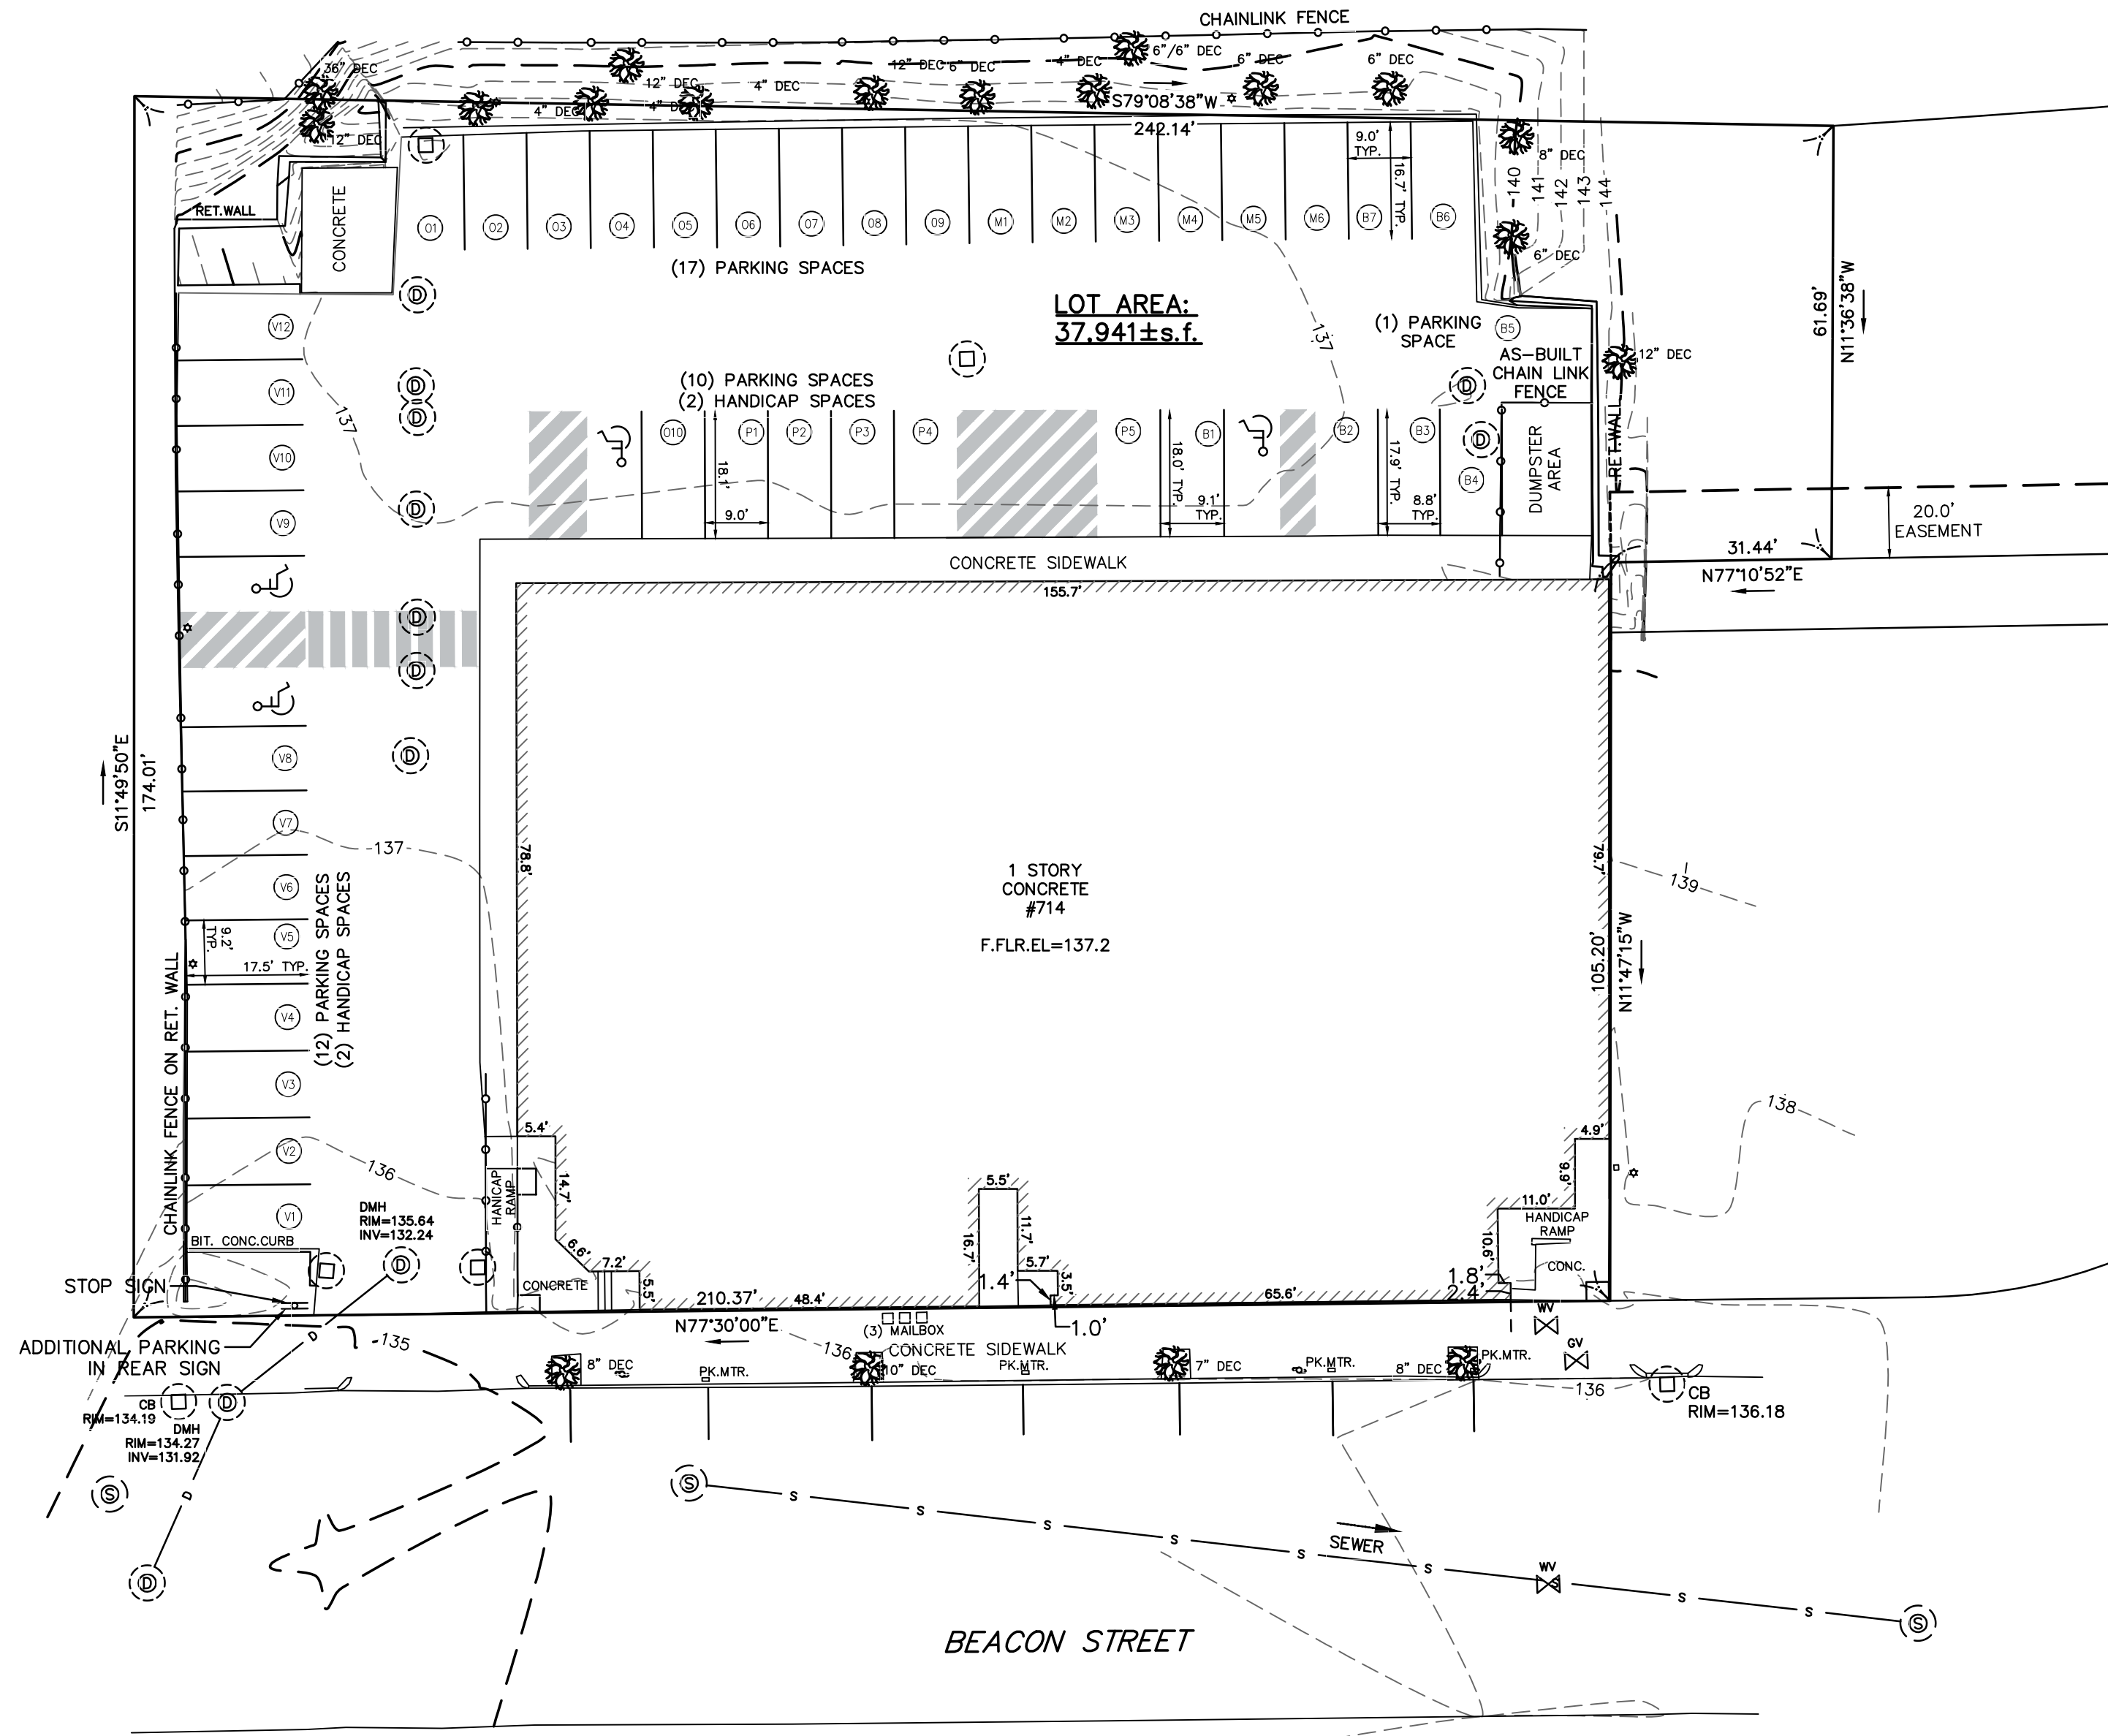



214201b-mod.dwg (2/2014)

LEGEND


- BUILDING
- PROPERTY LINE W/
BEARING DISTANCE S81°56'34"E
116.23'
- CONTOUR 70'
- STOCKADE FENCE
- CHAINLINK FENCE
- PICKET FENCE
- SEWER LINE
- DRAIN LINE
- WATER LINE
- GAS LINE
- GAS VALVE
- WATER VALVE
- DRAIN MANHOLE
- SEWER MANHOLE
- CATCH BASIN
- UTILITY POLE
- LIGHT POLE
- DECIDUOUS TREE DEC. 22"
- CONIFEROUS TREE CON. 12"

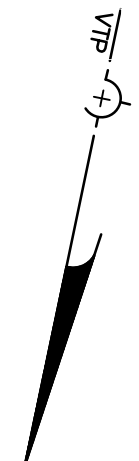

PARKING SPACES		
DESCRIPTION	LEGEND	QTY
BANK	B	7
HANDICAP	H	4
MEDICAL OFFICE STAFF	M	6
OPEN	O	10
POST OFFICE	P	5
VISITOR PATRON	V	12
TOTAL		44

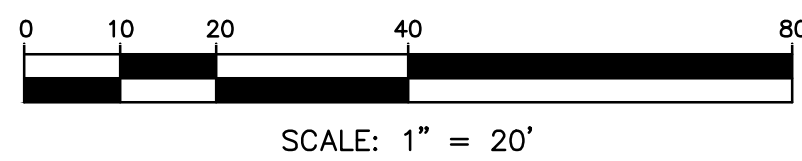

FINAL AS-BUILT PLAN
 NEWTON, MASSACHUSETTS
 SHOWING FINAL AS-BUILT AT
 #714 BEACON STREET
 SCALE: 1in.=20ft. DATE: SEPTEMBER 4, 2015

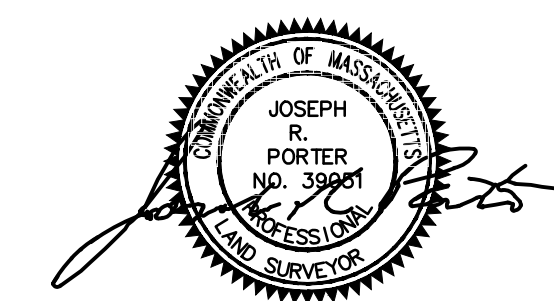

PROJECT: 214201
VTP
 ASSOCIATES
 INC.

LAND SURVEYORS - CIVIL ENGINEERS.
 132 ADAMS STREET, 2nd FLOOR, SUITE 3.
 NEWTON, MA 02458
 (617) 332-8271